True, Roland

ORIGINAL — To be sent to Division of Health Engineering, Augusta, Maine 04333 by the LPI

MAINE DEPARTMENT OF HUMAN SERVICES APPLICATION FOR PRIVATE SEWAGE DISPOSAL PERMIT	This is NOT a permit; this form when completed must be presented to the Local Plumbing Inspector to obtain a permit	Page 1 of 2

Town	Street, Road, etc. / If on water body, give name	Plumbing Permit No.	Date of Plumbing Permit
Augusta	Cross Hill	44993EP	9-22-81

Owner of property: ~~David P. Whitney~~ Roland True Sr.
Owner's address: R.F.D. # 6 Augusta, Me.
Size of lot: ~~2~~ 10 — ○ Sq. feet ● Acres

Name & type of establishment if other than private home: 270 gpd
Is lot Zoned? ○ Yes ● No
Type of Zoning: ○ Shoreland ○ Resource Protection

Name of applicant Owner's agent: 9
Applicant's address Street, Box, etc.:
Tel. No.: 3503 ~~622-4386~~
Town:
Zip Code: 04330
Applicant's signature X
Owner's signature: Sharon L. True
Date:
Date:

If you plan to use a previous subdivision approval in lieu of site investigation, please submit one of the following:
○ Deed restriction re. private sewage disposal
○ Copy of the subdivision's soils report
○ Soils report from a State Agency

Subdivision name: Lot No.:

This application is for: ● New System ○ Expanded System ○ Replacement System ○ Replacement of ○ Treatment Tank Only ○ Disposal Area Only

The water supply for this property is: ○ Dug well, depth _____, lining _____; ● Drilled well, to be drilled Spring ○
depth _____, lining _____; Surface water ○ Body, ○ Course—○ with disinfection, ○ without disinfection. ○ Public Utility, name _____

SITE INVESTIGATION

Show location of pits and/or borings on sketch on page 2, and refer to completed sample form and Chapter 4 of the Code, II.

Soil Profile No. 1
● Pit ☐ Boring

Description of soil strata encountered / Thickness each soil strata:
- Organic strata: ½ inches
- 1st strata: dark brown sandy loam, 8 inches
- 2nd strata: light brown sandy loam, 24 inches
- 3rd strata: olive sandy loam, 15" inches

Depth from bottom of organic horizon to:
- Total Depth of observation hole: 47" inches
- Max. Ground water table—mottling: ○ None Evident, 36 inches
- Impervious layer, clay, etc.: ● None Evident, inches
- Bedrock: ● None Evident, inches
- Type of Bedrock:

Surface slope: 1 %

Soil Group & Condition per Table 9-1 of the Code, II: 2C

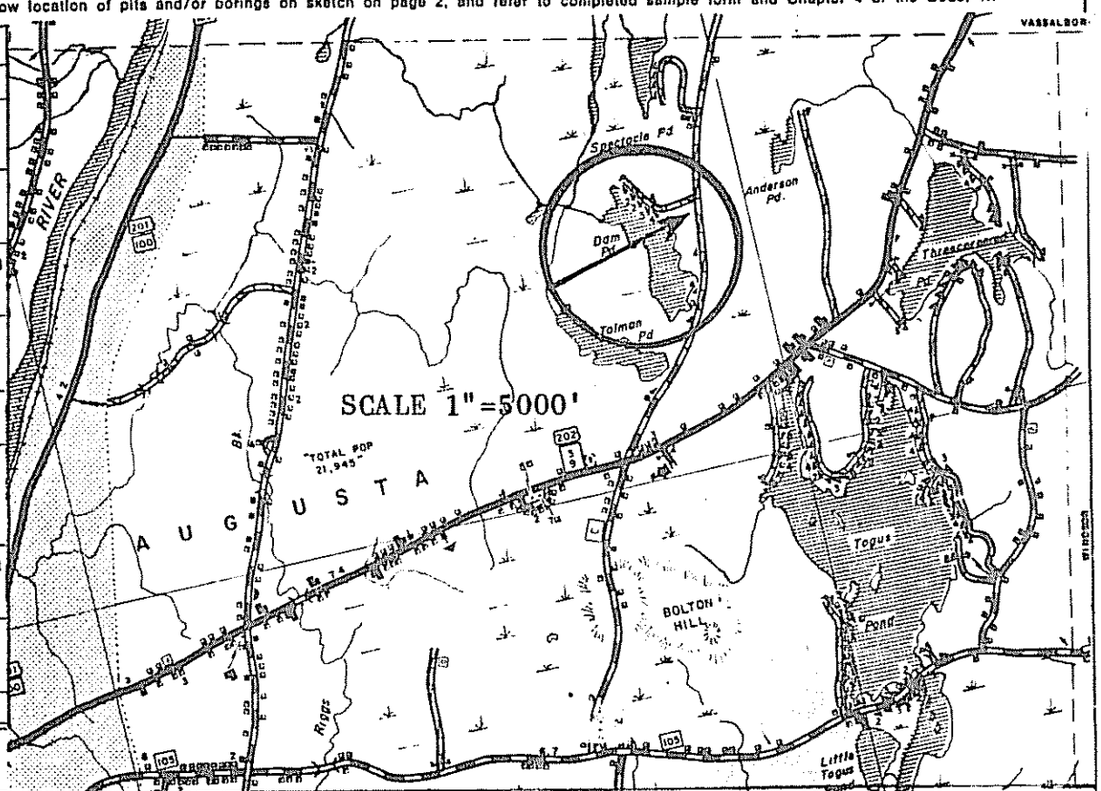

On June 7, 1978 (date), a site investigation for this project was completed. I conducted this soil evaluation and certify that the results indicated above best represent the soil conditions found. I recommend the following type and size of private sewage disposal system. I also recommend the proposed private sewage disposal system layout and location shown on page 2.

Signature: Lloyd C. Kane
Health Engineering License No. 0042
Date signed: June 7, 1978

PRIVATE SEWAGE DISPOSAL SYSTEM PROPOSED

Show location of system and details on sketches on page 2, and refer to completed sample form

SYSTEM:
● COMBINED SYSTEM
○ SEPARATED SYSTEM
If separated system—type of human waste disposal system to be used:
○ Sealed Vault Privy
○ Open Pit Privy
○ Compost Toilet
○ Incinerator Toilet
○ Chemical Toilet
○ Other, describe

See Chapter 9 of the Code, II.

TREATMENT TANK:
● Septic Tank
● Concrete
○ Fiberglas
○ Metal
Size in gallons: 1000

○ Aerobic Tank
Manufacturer—
Model No.
Size in gallons

SUBSURFACE ABSORPTION AREA

Type:
○ Trench System: Total trench length. _____
● Bed System: Length 44 Width 20
○ Chamber System: ○ Type A ○ Type B — Number ○ Single File ○ Cluster
○ Mound System: Length _____ Width _____ at base
○ Special System: Length _____ Width _____

SIZE:
○ Very Small
○ Small
○ Medium
● Medium Large
○ Large
○ Extra Large

WAIVER
○ Required
● Not Required

SITE MODIFICATION
Fill will be: 0 in. uphill; 4 in. downhill

DETAILS
● A Distribution Box is recommended
Pumping is—○ required, ● is not required.
The Dose will be _____ gallons

DISTANCES
● Yes ○ No: The proposed subsurface absorption area will be located at least 100 feet from any and all wells; springs; surface water bodies and courses (lake, pond, ocean, brook, stream, river); swamps; marshes; and bogs.
● Yes ○ No: The proposed subsurface absorption area will be located at least 300 feet from any and all wells and springs producing 2000 gallons or more of water per day and any public water supplies.

PROPERTY / LOT LOCATION MAP

Lot is 1.5 miles from Route 3.

Location—roads, landmarks

FOR THE USE OF LPI ONLY

○ Denial: Application is denied for following reasons; portions of the Code II are cited.
Form is incomplete (_____ pg.) as to ○ General Info, ○ Site Investigation, ○ System Proposed, ○ Site Plan, ○ Disposal System Plan, ○ Cross-Section, ○ Statement. See Section 2.3.
○ Site Investigation indicates site is ○ totally unsuitable for disposal system; Sections 4.5 and 9.5, Table 9-1 Group 9 and 10. ○ Unsuitable for system proposed; Sections 4.3, 4.6, 9.5, Table 9-1.
○ System Proposed does not conform to Code; See Sections 9. _____
○ Site Investigation indicates site modifications are necessary; See Sections ○ 4.3, ○ 4.4, ○ 4.6, ○ 8.7.
○ _____
○ Miscellaneous _____ See Section _____
● Acceptance: Application for permit is approved ○ with condition specified, comply with Section _____
● without condition.

Signed LPI: Richard P. Baker Date: 9-21-81

HHE-200 1/77

APPLICATION FOR PRIVATE SEWAGE DISPOSAL PERMIT

(For systems disposing of less than 2000 gallons per day)

Town	Street, Road, etc. If on water body, give name	Owner of property
Augusta	Cross Hill Road	David P Whitney

Site Plan

Scale 1" = 100 Ft. or _____

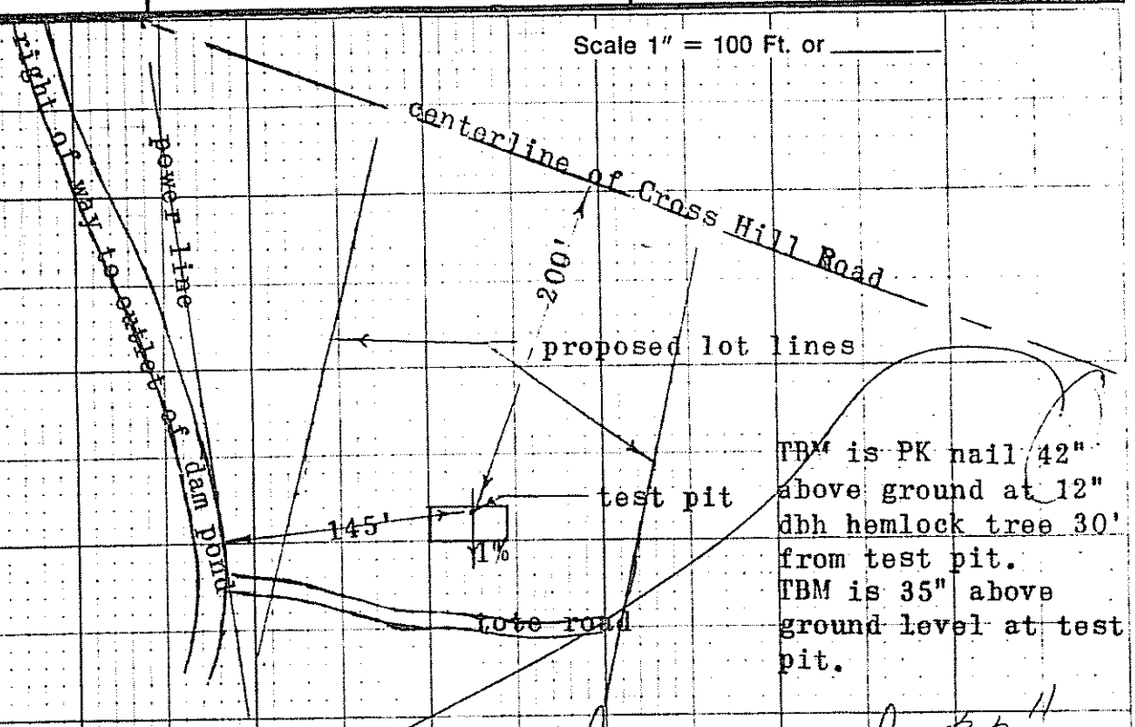

Should have read 32"

Sept 3, 1981 Lloyd Rowe

Private Sewage Disposal Plan

Scale 1" = 20' or _____

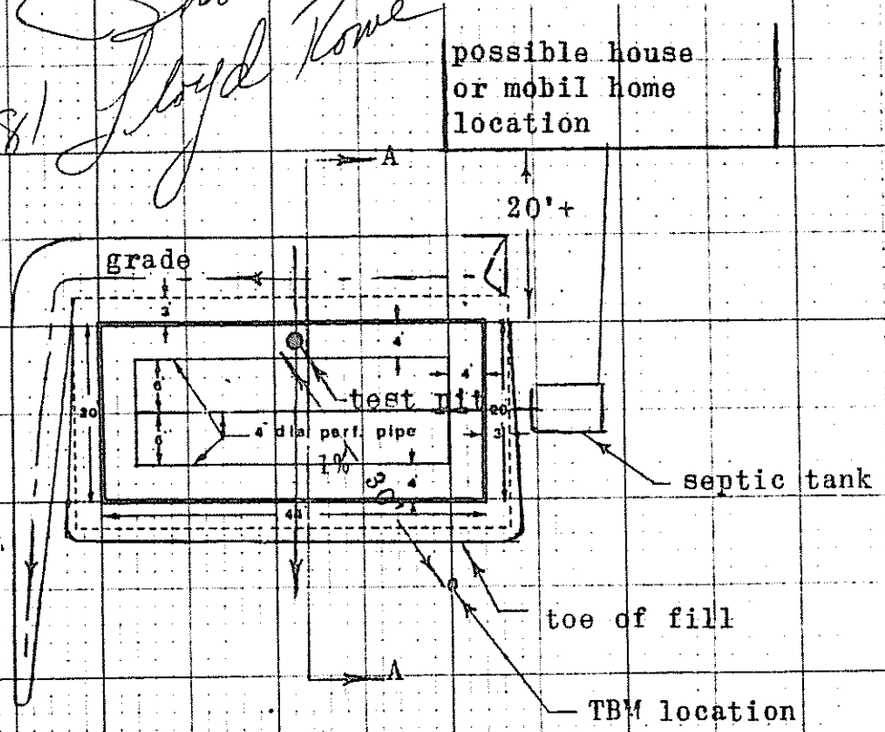

Subsurface Absorption Area Cross-section

Scale: Vertical — 1" = 5' or _____
Horizontal — 1" = 20' or _____

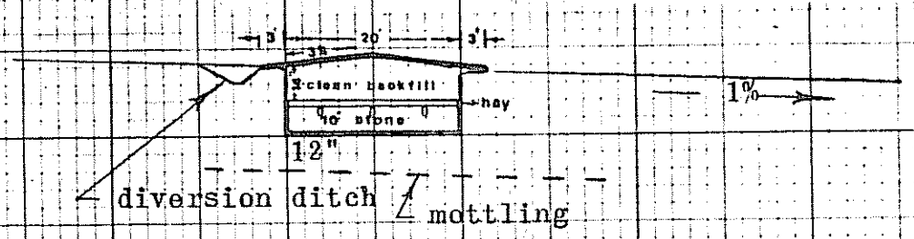

SECTION A-A

Lloyd C Rowe

HHE - 200 1/77

Statement: (no permit may be issued unless signed)

I certify that all the information submitted to be true and correct; and I understand that issuance of a permit is based upon the information and plans submitted by the applicant. I also understand that any falsification of this application is reason to deny a permit to install a private sewage disposal system and that the permit is valid for a six (6) month period from the date of permit issuance. I understand that no guarantee is intended or implied by reason of any advice or approval given by the Administrative Authority or its agent.

Signature Required

Date: _____

Applicant: _____

Owner: X Sharon L Fine